


These documents must be retained on site. Inspections may not be carried out if they are not.

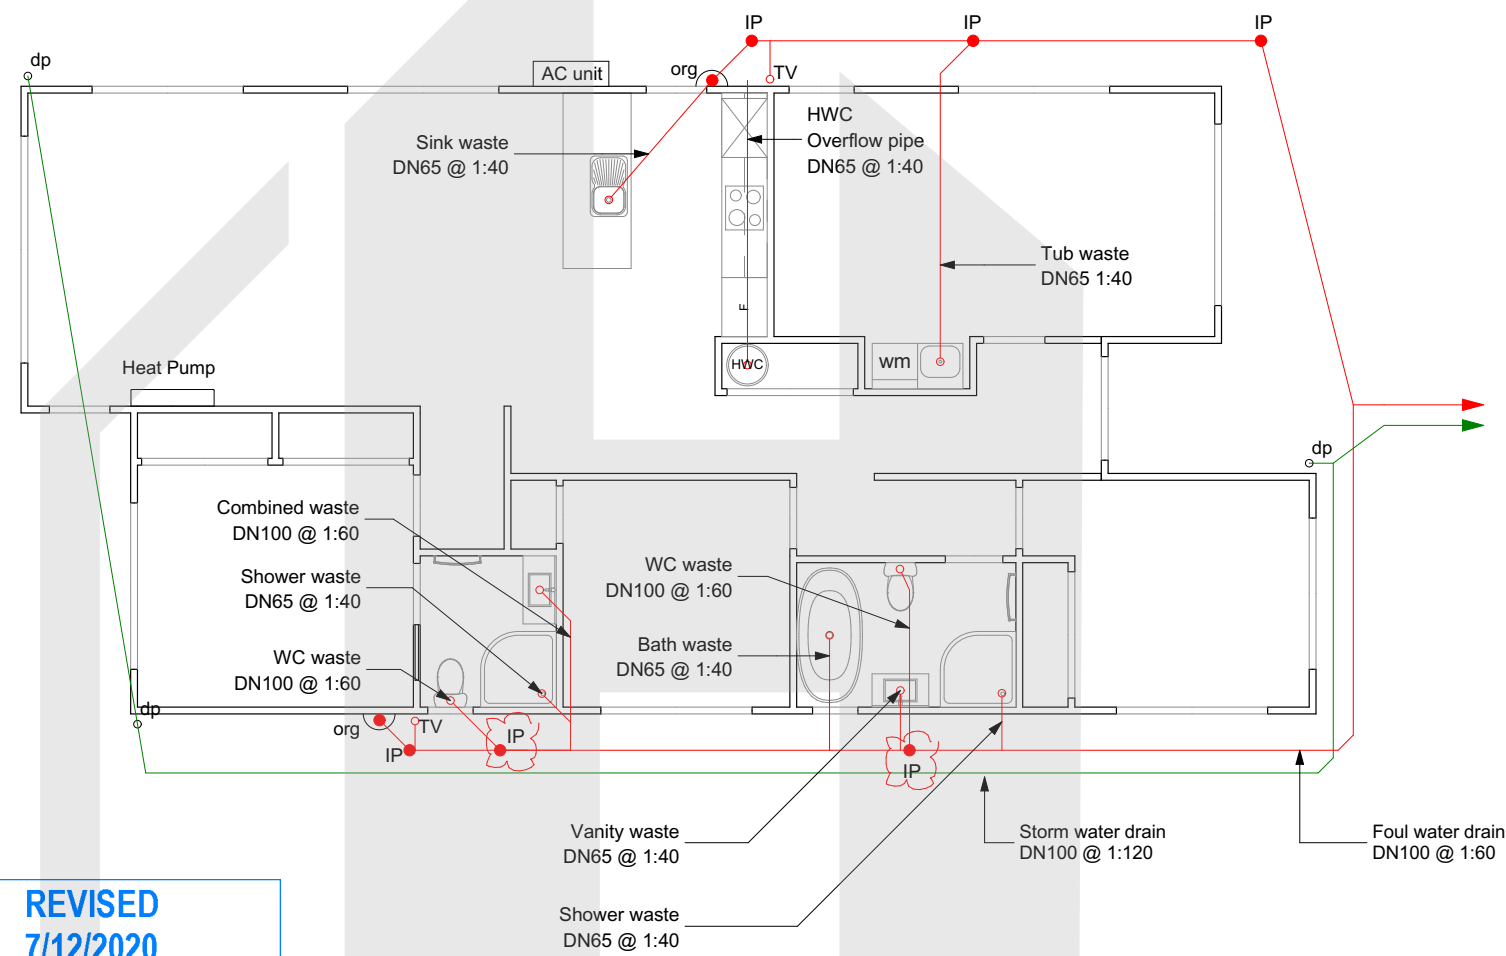

REVISED  
7/12/2020  
HUTT CITY COUNCIL

BUILDING CONSENT  
  
GRANTED  
7/12/2020  
  
HUTT CITY COUNCIL

## Plumbing & Drainage Notes

**General plumbing notes**  
Contractor to ensure all work complies with the NZ Building Code and relevant standards, along with local territorial authorities' bylaws prior to work commencing.  
All Foul Water plumbing work to comply with AS/NZS3500.2  
All Storm Water plumbing work to comply with E1/AS1 & AS/NZS3500.3  
All bends and junctions under slab must not be less than 45° (in plan).  
Contractor/Plumber to submit as laid drainage plan to council upon completion of all plumbing/drainage works

**Water supply**  
Water supply pipe materials to comply with G12/AS1 table 1:  
Hot & Cold: copper, galvanised steel or polybutylene  
Cold only: uPVC or polyethylene  
All hot and cold water pipework through slab shall be in DN65 uPVC conduit.  
All hot water piping shall be thermally insulated to comply with H1/AS1 clause 5.0 hot water

**systems**  
All water supply pipe sizes installed to comply with G12/AS1 table 4  
Sink, laundry, bath, basin 15mmØ  
Shower 20mmØ  
Pipes based on a maximum pipe length of 20 metres

Ensure hot water temperature at any sanitary fixture used for personal hygiene does not exceed 55°

**Fixture trap and waste sizes**  
Fixture traps for hand basins to be DN40 trap, DN65 drain pipe  
Fixture traps from sinks, bath, showers and tubs to be DN65 trap, DN65 drain.  
Fixture traps from WC to be DN100 trap and DN100 drain.

**Continuous spouting rainwater system**  
Continuous spouting rainwater system, prefinished Colorcote spouting and downpipes, DN80 downpipes unless otherwise noted.

**Hot water cylinder**  
180L HJ Cooper electric hot water cylinder. Installed to manufacturers specification. HWC to be installed

over safe tray. Relief valve drains to be of copper pipe, have no restrictions or valves, have a continuous fall from the relief valve to the outlet, discharged in a visible position which does not present a hazard or damage to other building elements.

**Proprietary acrylic shower**  
Proprietary acrylic showers to be installed in accordance with E3 internal moisture. Acrylic wall linings shall extend to ceiling. Junctions used between the tray and wall linings shall be constructed in accordance with E3 Figure 4 (a) or (b) Refer details. All glazing within a wet area to be grade A safety glass.

**Overflow relief gully**  
Overflow relief gully to be installed so that the top of the overflow gully riser is at a height of min. 150mm below the lowest fixture, and min. 75mm above the finished ground level and the overflow level of the gully dish will be no less than 25mm above paved surfaces and will have a grating that will allow surcharge. Waste pipes that discharge to the gully trap are arranged to permit easy cleaning of the gully trap.

### 3.6.6 Separation from other underground services

The separation between any underground drain and any other service other than consumer gas piping, electrical communication service or water service shall be at least 100 mm or 300 mm from a stormwater drain exceeding DN 100 (see Figure 3.3).


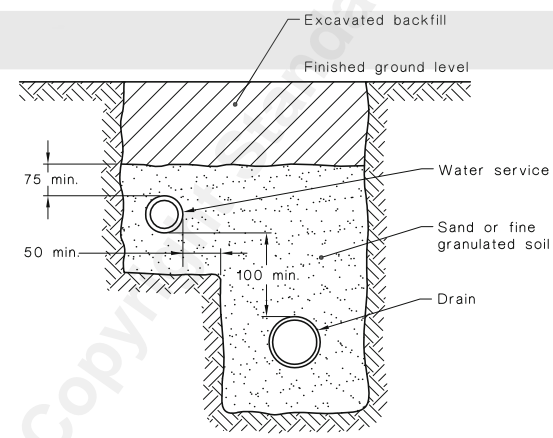



FIGURE 3.3 TYPICAL SHARED TRENCH

## Plumbing Legend

- dp DN80 downpipe
- org Overflow relief gully
- TV DN50 terminal vent
- IP Inspection point
- aav Air admittance valve
- HWC 180L Hot water cylinder



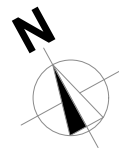

(04) 595 1287  
www.fridayhomes.co.nz

Head office: 6-8 Meachen Street, Seaview. PO Box 30389, Lower Hutt  
© Copyright Kakariki IP Limited 2016 trading as Friday Homes

COPYRIGHT RETAINED BY DMAC HOMES LTD.  
CONTACT IMMEDIATELY IF AN ERROR OR DISCREPANCY IS DISCOVERED

**S2-G Cromwell**  
Lot 15, Stage 1  
Manapouri Grove, Kelson, Lower Hutt

**Plumbing Plan**



ISSUE DATE: 2/12/2020	REV. DATE:	SHEET NO. <b>108r1</b>
REF: 19093		
SCALES (A3): 1:100, 1:1.6268		CODE:

These documents must be retained on site. Inspections may not be carried out if they are not.

**BUILDING CONSENT**

**GRANTED  
7/12/2020**

**HUTT CITY COUNCIL**

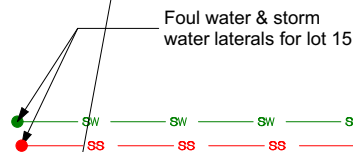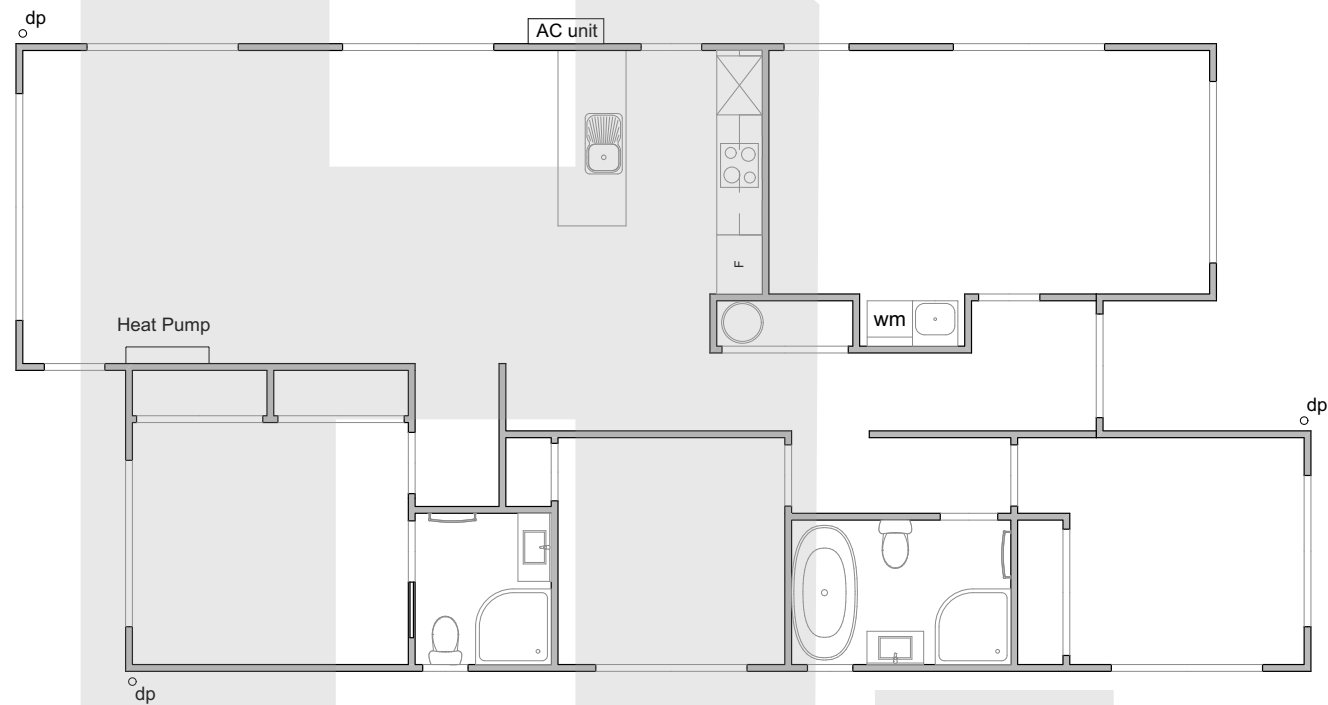

2 As - Laid Plumbing Plan 1:100

**REVISED  
12/03/2020  
HUTT CITY COUNCIL**



(04) 595 1287  
www.fridayhomes.co.nz

Head office: 6-8 Meachen Street, Seaview, PO Box 30389, Lower Hutt  
© Copyright Kakariki IP Limited 2016 trading as Friday Homes

COPYRIGHT RETAINED BY DMAC HOMES LTD.  
CONTACT IMMEDIATELY IF AN ERROR OR DISCREPANCY IS  
DISCOVERED

**S2-G Cromwell**  
Proposed Lot 15, Stage 1  
Manapouri Grove, Kelson, Lower Hutt

**As - Laid Plumbing Plan**

ISSUE DATE:	9/03/2020	REV. DATE:		SHEET NO. <b>109</b>
REF:	19093			
SCALES (A3):	1:100	CODE:		